THIS PROJECT INVOLVES THE FULL RECONSTRUCTION OF THE TRAFFIC SIGNAL AT THE INTERSECTION OF MD 450 (ANNAPOLIS ROAD) AND MD 769B (EDMONSTON ROAD) IN PRINCE GEORGE'S COUNTY, LED VEHICULAR SIGNAL HEADS, ACCESSIBLE PEDESTRIAN SIGNALS, COUNTDOWN PEDESTRIAN SIGNALS AND VIDEO DETECTION FOR PRESENCE AND SAMPLING WILL BE INSTALLED, MD 450 IS ASSUMED TO RUN IN AN EAST-WEST DIRECTION.

INTERSECTION OPERATION

THE INTERSECTION WILL CONTINUE TO OPERATE IN A NEMA FOUR-PHASE, FULL TRAFFICACTUATED MODE WITH EXCLUSIVE-PERMISSIVE PHASING FOR EASTBOUND MD 450. THE CONCURRENT MAINLINE PEDESTRIAN PHASE, THE ALTERNATE SIDE STREET PEDESTRIAN PHASE AND THE SOUTHBOUND RIGHT TURN OVERLAP PHASE SHALL REMAIN.

CONTROLLER REQUIREMENTS

INSTALL A NEW EIGHT-PHASE FULLY ACTUATED TRAFFIC SIGNAL CONTROLLER, AND ASSOCIATED HARNESSES IN A NEMA SIZE "6" BASE MOUNTED CABINET. INSTALL ONE (I) VIDEO DETECTION INTERFACE FOR I-4 CAMERAS AND ONE (I) CENTRAL CONTROL UNIT.

APS WILL FUNCTION AS FOLLOWS:

TO CROSS ANNAPOLIS ROAD

- A. WHEN A PEDESTRIAN LOCATES AND PRESSES THE PUSHBUTTON FOR AN EXTENDED TIME, THE PUSHBUTTON MESSAGE WILL BE "WAIT TO CROSS ANNAPOLIS".
- B. WHEN THE "WALK" PHASE BEGINS, THE MESSAGE WILL BE A RAPID TICK, WHICH WILL LAST FOR THE DURATION OF THE "WALK" PHASE.

TO CROSS EDMONSTON ROAD

- A. WHEN A PEDESTRIAN LOCATES AND PRESSES THE PUSHBUTTON FOR AN EXTENDED TIME, THE PUSHBUTTON MESSAGE WILL BE "WAIT TO CROSS EDMONSTON".
- B. WHEN THE "WALK" PHASE BEGINS, THE MESSAGE WILL BE A RAPID TICK, WHICH WILL LAST FOR THE DURATION OF THE "WALK" PHASE.

 $A,C,D,E,F,G,N,O,P,Q,T,U,V,W,bb \ A,E,G,N$ 

PHONE DROP

A,B,C,D,E,F,G,H,J,M, N,O,P,Q,R,S,T,U,V,W, X,Y,Z,aa,bb,PTS

A,B,C,D ~

A,E,F,G,H,J,M,N,O,P,

A,B,H,J,R,X <

Q,R,S,T,U,V,W,X,bb

THE CONTRACTOR SHALL NOTIFY MR, ROBERT SNYDER OF SHA AT (410) 787-7635 TO ARRANGE FOR THE PHONE DROP LINE INSTALLATION, THE CONTRACTOR IS TO NOTIFY MR. SNYDER WITH THE NEAREST STREET ADDRESS, ZIP CODE AND PHONE NUMBER.

A,M,S

818402

-5081

WIRING DIAGRAM

THE CONTACT PERSONS FOR DISTRICT #3 / OOTS ARE AS FOLLOWS:

Ms.Felicia Murphy Assistant District Engineer - Traffic

Phone: 301-513-7358

Mr. Victor Grafton
District Utility Engineer
Phone: 301-513-7350

District #3

Mr. Vernon Stinnett Assistant District Engineer - Maintenance Phone: 301-513-7304

Mr.Kevin Nowak Assistant District Engineer - Construction Phone: 301-513-7385

Office Of Traffic & Safety

Mr. Richard L. Daff Sr. Chief, Traffic Operations Division Phone: 410-787-7630

Mr. Robert Snyder Assistant Division Chief, Traffic Operations 410-787-7630

Mr.Edward Rodenhizer Team Leader Signal Operations Phone: 410-787-7650

Mr. Eugene Bailey Team Leader Sign Operations 410-787-7670

A,C,D,F,P,Q,V,W,bb

A,C,D,F,P,V,bb

The Power Company Representative is: Potomac Electric Power Company 8300 Old Marlboro Pike Upper Marlboro, Maryland 20772 Phone: 301-961-5325 PROPOSED SIGNAL EQUIPMENT

AND PAVEMENT MARKING LAYOUT

EQUIPMENT\_LIST 'A'

EQUIPMENT TO BE FURNISHED BY THE SHA.

<u>DESCRIPTION</u>

EQUIPMENT: 1-4 CAMERAS

I EA - MI-5(6)(48 IN. x 72 IN.)
"EAST, MD 450, LEFT ARROW"

IEA - MI-5(6)(30 IN. x 48 IN.)
"WEST, MD 450, RIGHT ARROW"

4 EA - RIO-3(I) (9 IN. X I5 IN.)

2 EA - RIO-3(I) (9 IN, X I5 IN.)

"PUSH BUTTON TO CROSS ANNAPOLIS ROAD"

"PUSH BUTTON TO CROSS EDMONSTON ROAD"

2 EA - D-3(I) (96 IN. x I6 IN.) "EDMONSTON ROAD" DUAL FACED

IEA - D-3(1) (96 IN. x 16 IN.) "ANNAPOLIS ROAD" SINGLE FACED

IEA - R3-5(2)(L) (60 IN. x 36 IN.) "DOUBLE LEFT ONLY"

ARM/POLE MOUNTED SIGN:

[UPDATED] SHEET ALUMINIUM MAST

[UPDATED] CONTROLLER CABINET, SIZE 6

[UPDATED] VIDEO DETECTION INTERFACE

[UPDATED] SHEET ALUMINIUM GROUND MOUNTED SIGN

<u>QUANTITY</u>

ΙEΑ

LEA


24 SF

9044

9086

9570

9571

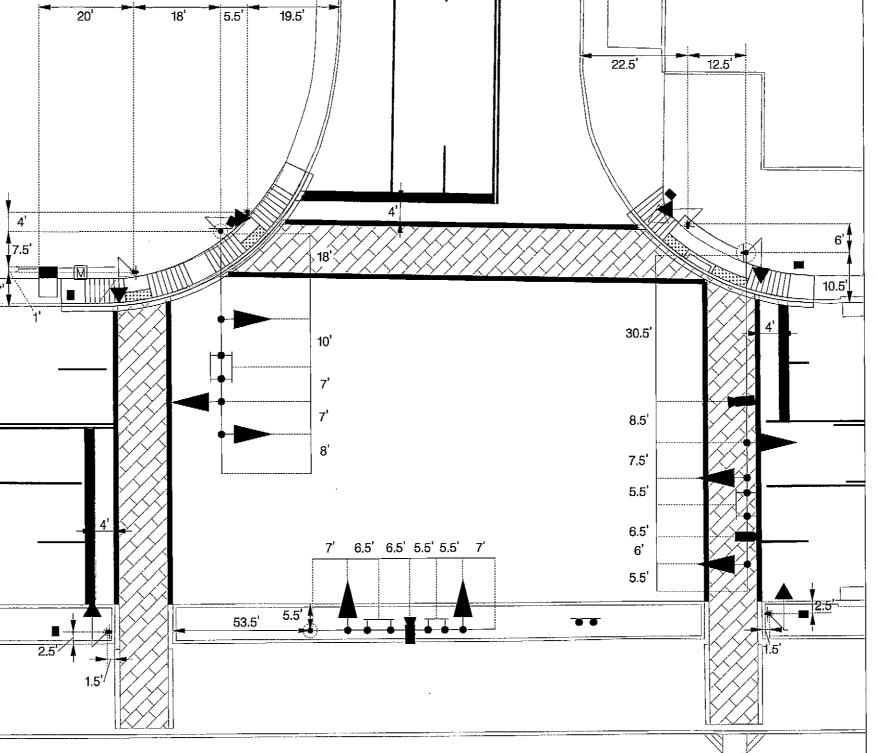

EQUIPMENT LIST 'B'

EQUIPMENT TO BE FURNISHED AND INSTALLED BY THE CONTRACTOR.

<u>DESCRIPTION</u>

<u>QUANTITY</u>

TEM NO	QUANTITI	DESCRIPTION
1003	2 EA	MAINTENANCE OF TRAFFIC
2002	5 CY	TEST PIT EXCAVATION
5004	550 LF	12 INCH HEAT APPLIED WHITE PERMANENT PREFORMED THERMOPLASTIC PAVEMENT MARKINGS
5005	120 LF	24 INCH HEAT APPLIED WHITE PERMANENT PREFORMED THERMOPLASTIC PAVEMENT MARKINGS
5007	700 LF	REMOVAL OF EXISTING PERMANENT PAVEMENT LINE MARKINGS - ANY WIDTH
6001	200 LF	STANDARD TYPE A COMBINATION CURB AND GUTTER 12 INCH GUTTER PAN 8 INCH DEPTH
6002	800 SF	5 INCH CONCRETE SIDEWALK
8001	LEA	2 WIRE CENTRAL CONTROL UNIT
8003	3 ЕА	8 INCH LED SIGNAL HEAD SECTION
8007	6 EA	AUDIBLE/TACTILE PEDESTRIAN PUSHBUTTON STATION AND SIGNS
8008	5 EA	BREAKAWAY PEDESTAL POLE (ANY SIZE)
8013	6 EA	LED 16 INCH COUNTDOWN PEDESTRIAN SIGNAL HEADS
8015	ΙEΑ	MAST ARM POLE & 38 FT MAST ARM ANY "T" DIMENSION
8017	1 EA	MAST ARM POLE & 70 FT MAST ARM ANY "T" DIMENSION
8018	I EA	MAST ARM POLE & 50 FT MAST ARM ANY "T" DIMENSION
802	I EA	REMOVE AND DISPOSE OF MATERIALS AND EQUIPMENT PER ASSIGNMENT
8025	3 ЕА	VIDEO DETECTION CAMERA AND CABLE
8030	25 LF	CABLE 1-CONDUCTOR, 2/O AWG THHN, THWN (ALUMINUM)
8034	200 LF	SCHEDULE 80 RIGID PVC CONDUIT UP TO 4 INCHES - SLOTTED
8035	325 LF	SCHEDULE 80 RIGID PVC CONDUIT UP TO 4 INCHES - TRENCHED
8036	40 LF	WOOD SIGN SUPPORTS UP TO 4 X 6
8037	60 SF	DETECTABLE WARNING SURFACES
8038	87 SF	INSTALL OVERHEAD OR GROUND MOUNTED SIGN (INCLUDING ALL HARDWARE)
8039	400 SF	REMOVE AND REINSTALL DECORATIVE BRICK
8040	500 LF	NO.6 AWG STRANDED BARE COPPER GROUND WIRE
8042	LEA	METERED SERVICE PEDESTAL EMBEDDED (100 OR 200 AMP)
8045	75 LF	ELECTRICAL CABLE I-CONDUCTOR NO.8 AWG-THHN/THWN
8046	6 EA	FURNISH AND INSTALL ELECTRICAL HANDHOLE
8050	27 EA	12 INCH LED VEHICULAR TRAFFIC SIGNAL HEAD SECTION
8054	750 LF	ELECTRICAL CABLE - 2 CONDUCTOR (NO. [4 AWG)
8056	850 LF	ELECTRICAL CABLE - 5 CONDUCTOR (NO. 14 AWG)
8057	1350 LF	ELECTRICAL CABLE - 7 CONDUCTOR (NO. 14 AWG)
8065	I EA	INSTALL CONTROLLER AND CABINET - BASE MOUNT

## EQUIPMENT LIST 'C'

EQUIPMENT TO BE REMOVED AND RETURNED TO SHA.

ITEM\_NO QUANTITY DESCRIPTION

NONE - ALL REMOVED EQUIPMENT SHALL BECOME THE PROPERTY OF THE CONTRACTOR

A -NO.6 STANDARD BARE COPPER GROUND WIRE

B CONTROL CABLE, 250 FT. VIDEO DETECTION CAMERA TO CONTROLLER

C CONTROL CABLE, 500 FT. VIDEO DETECTION CAMERA TO CONTROLLER

-ELECTRICAL CABLE - 7 CONDUCTOR (NO. 14 AWG)

M N O - ELECTRICAL CABLE - 5 CONDUCTOR (NO.14 AWG) -ELECTRICAL CABLE - 2 CONDUCTOR (NO.14 AWG)

A,C,D,F,O,P,Q,U,V,W,bb

C,D,F,bb <

Y | Z | ELECTRICAL CABLE I-CONDUCTOR, NO. 8-AWG THHN/THWN

PPS PROPOSED UNDERGROUND POWER SERVICE ELECTRICAL CABLE I-CONDUCTOR, #2/O AWG-THHN/THWN

PTS PROPOSED UNDERGROUND TELEPHONE SERVICE TO BE INSTALLED BY OTHERS

M-METERED SERVICE PEDESTAL

PROPOSED GROUND ROD - 3/4 INCH DIAMETER X IO FOOT LENGTH

PHASE CHART

		2	3	4	1.0	5	6	7	8	9	10	11	12	13	
			J	4	4a	)	0	1	0	J	10		12	١٥	
	(Y) (I) (H) (H) (H) (H) (H) (H) (H) (H) (H) (H	(R) (AY-)(Y) (G) (G)	(B)	R Y G	R Y G	R Y B	R Y G	R Y Y G G	<b>#89</b>	<b>12</b> 00	<b>£</b> 68	<b>\$80</b>	<b>1 1 1 1 1 1 1 1 1 1</b>	\$BB	i
PHASE 2 & 6	G	G	G	G	G	G	R	R	W	W	DW	DW	DW	DW	<u> </u>
PHASE 2 & 6 PED CLEARANCE	G	G	G	G	G	G	R	R	FL/DW	FL/DW	DW	DW	D₩	DW	<u> </u>
PHASE 2 & 6 CHANGE	Y	Y	Y	Υ	Y	Y	R	R	DW	DW	DW	DW	DW	DW	6
PHASE 2 & 5	<del>- 6</del> G	<del>- G</del> G	G	R	R	R	R	R G►	DW	DW	DW	DW	DW	DW	<u></u>
PHASE 2 & 5 CHANGE	4 Y Y	<del>- Y</del> Y	Y	R	R	R	R	R Y	DW	DW	DW	DW	DW	DW	
PHASE 4	R	R	R	R	R	R	G	G	D₩	DW	DW	DW	DW	DW	
PHASE 4 CHANGE	R	R	R	R	R	R	Y	Υ	DW	DW	DW	DW	DW	DW	H   H '
PHASE 4 ALT	R	R	R	R	R	R	G	G	DW	DW	₩	W	W	W	
PHASE 4 ALT PED. CLEARANCE	R	R	R	R	R	R	G	G	DW	DW	FL/DW	FL/DW	FL/DW	FL/DW	
PHASE 4 ALT CHANGE	R	R	R	R	R	R	Y	Y	DW	DW	DW	DW	DW	D₩	H
FLASHING OPERATION	FL/Y	FL/Y	FL/Y	FL/Y	FL/Y	FL/Y	FL/R	FL/R	DARK	DARK	DARK	DARK	DARK	DARK	+ ==

TOD No: XX351-12 SHA No: PG769A4A/K5A MD 450 @ MD 769B

TS NO. 541C-GI DRAWING **SG-02** OF 02



STATE OF MARYLAND
DEPARTMENT OF TRANSPORTATION
STATE HIGHWAY ADMINISTRATION
OFFICE OF TRAFFIC & SAFETY
TRAFFIC ENGINEERING DESIGN DIVISION

MD 450 (ANNAPOLIS ROAD)

AT MD 769B (EDMONSTON ROAD)

BLADENSBURG, MARYLAND

GENERAL INFORMATION

SCALE NONE	_ ADVERTISED DATE_	8 /2010 CON	TRACT NO. <u>XX3515168</u>
DESIGNED BY	MCG	COUNTY	PRINCE GEORGE'S
DRAWN BY	MCG	LOGMILE	160045000.42
CHECKED BY	BAB CJW	TIMS NO	K038
F.A.P. NO		TOD NO	

SHEET NO. 02 OF 02

STV Incorporated
7125 Ambassador Road, Suite 200
Baltimore, MD 21244
www.stvinc.com

PLOTTED: Monday, July 26, 2010 AT 09:42 AM FILE: I:\PROJECTS\4014255\4014255\_0027\Drawings\TRA\Edmonston\pSG-N002\_MD450.dgn